
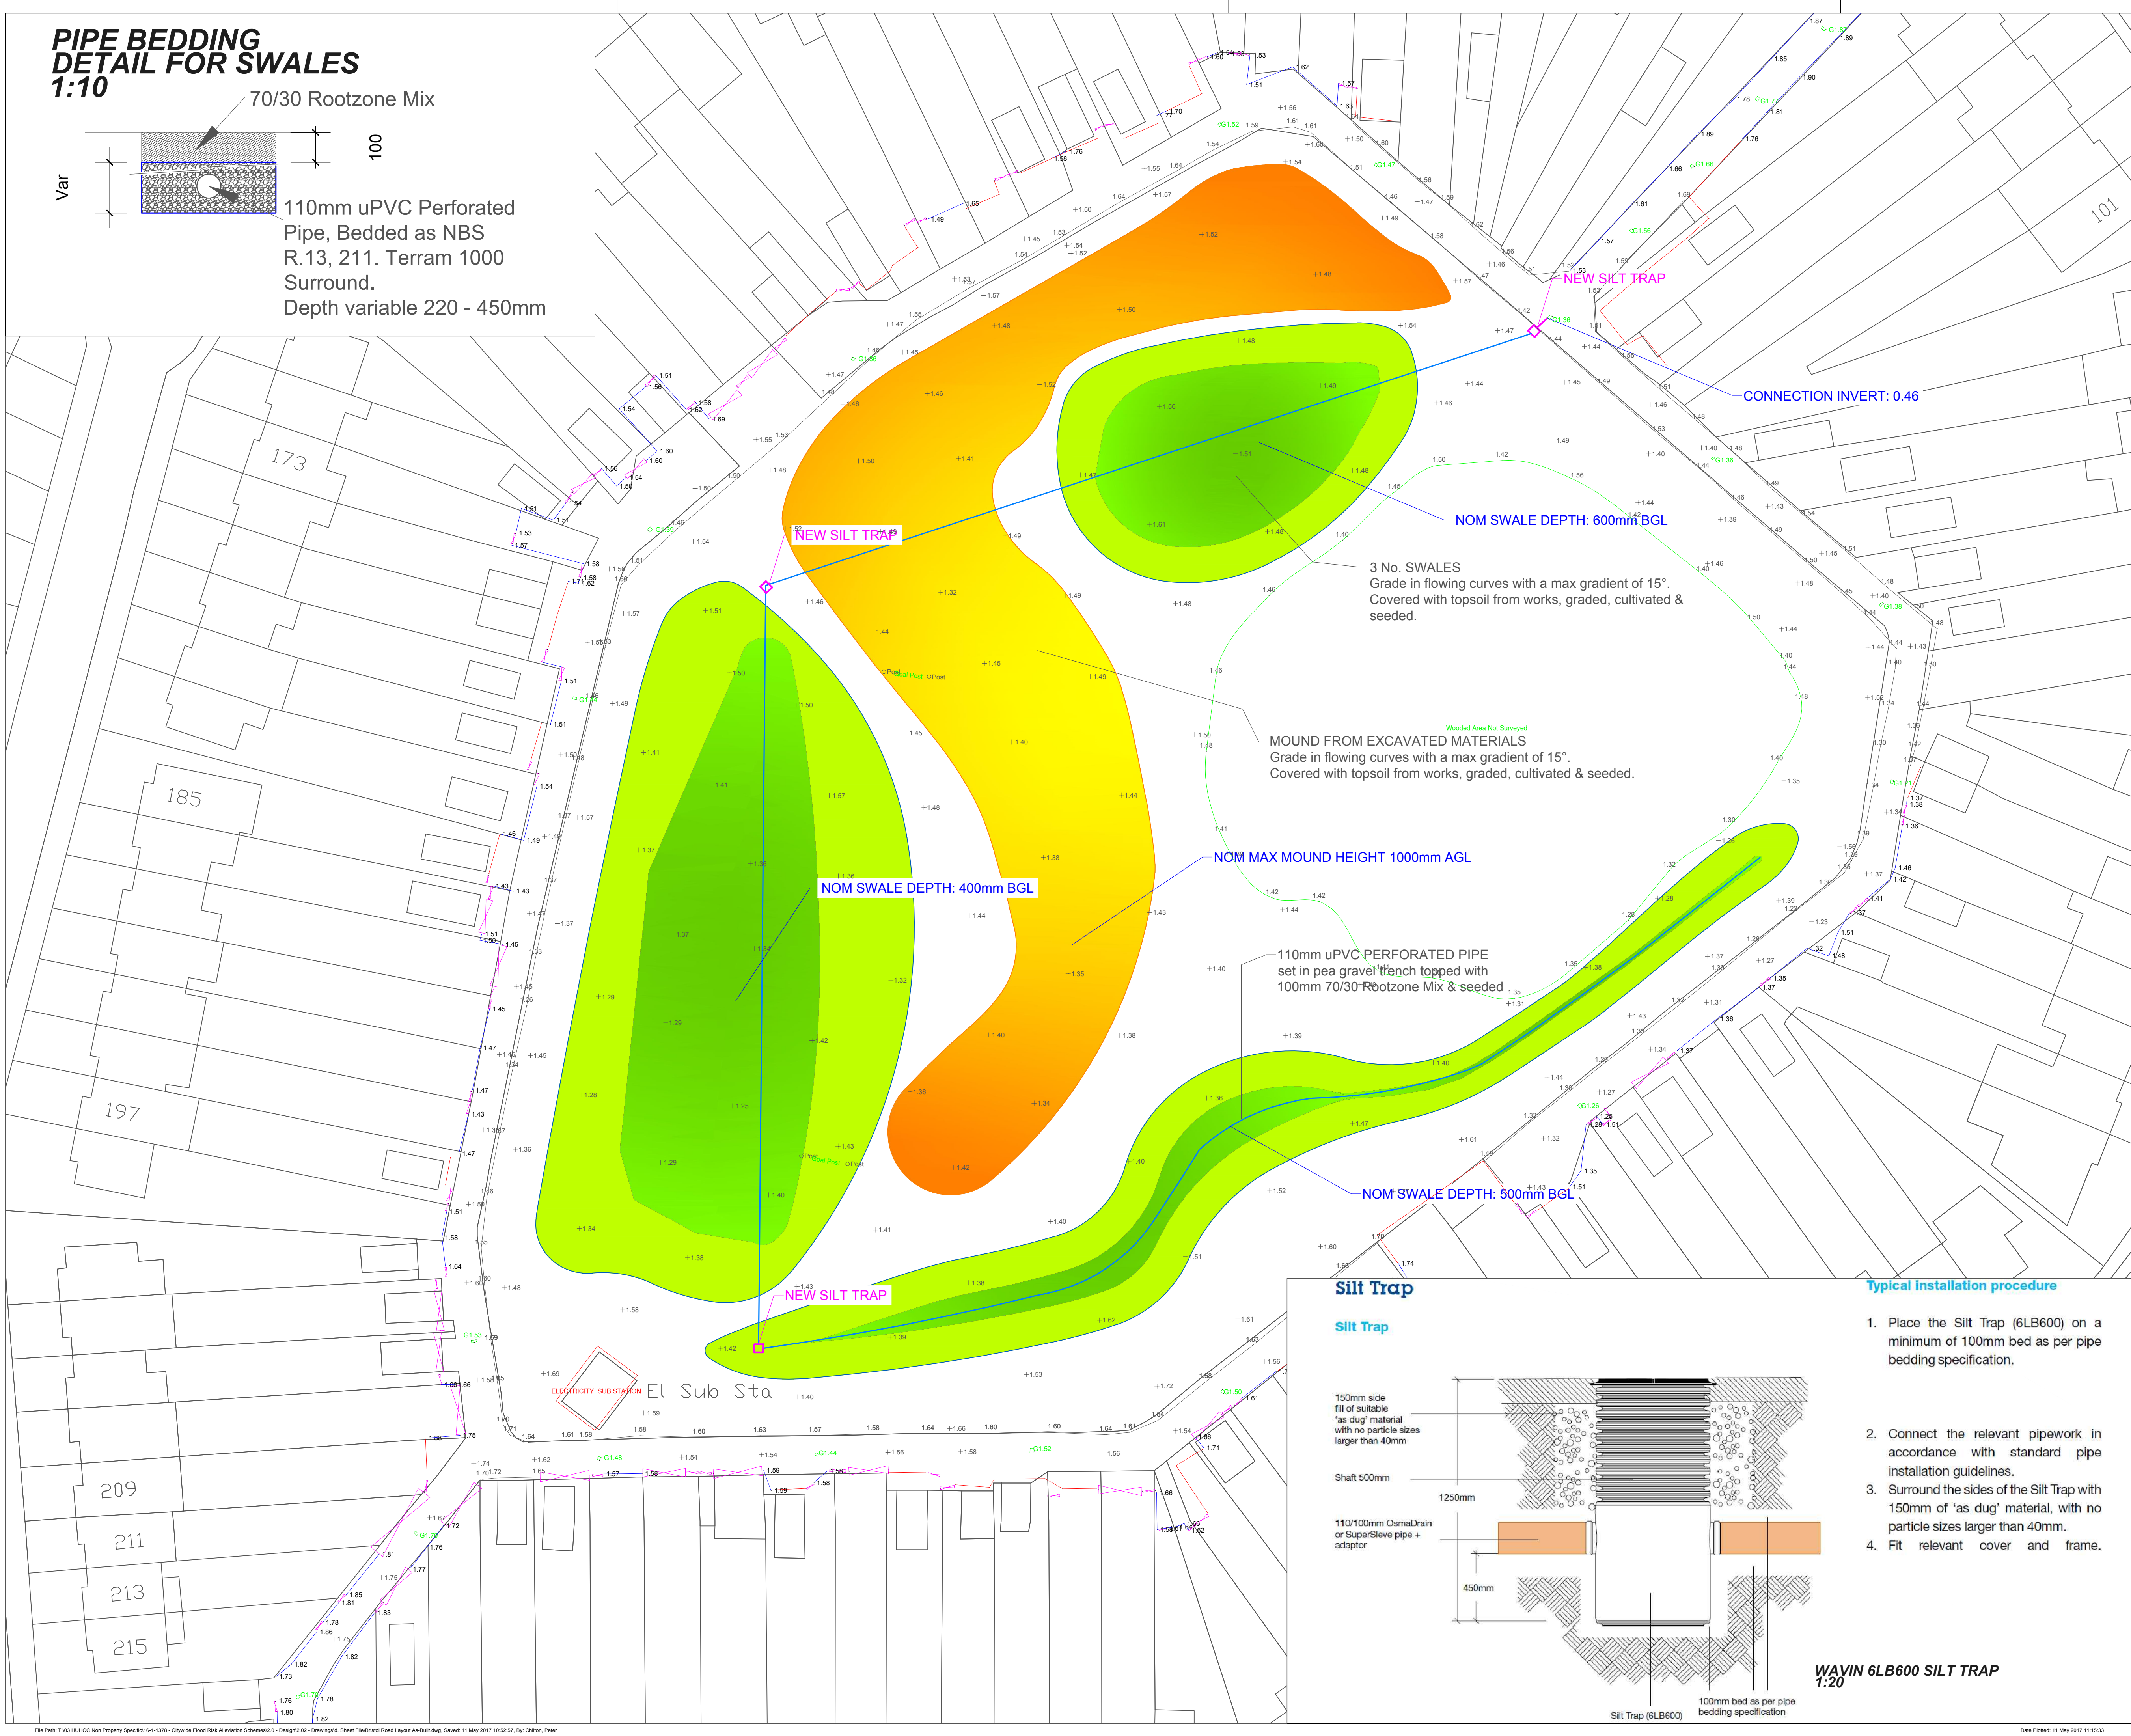


PIPE BEDDING
DETAIL FOR SWALES
1:10

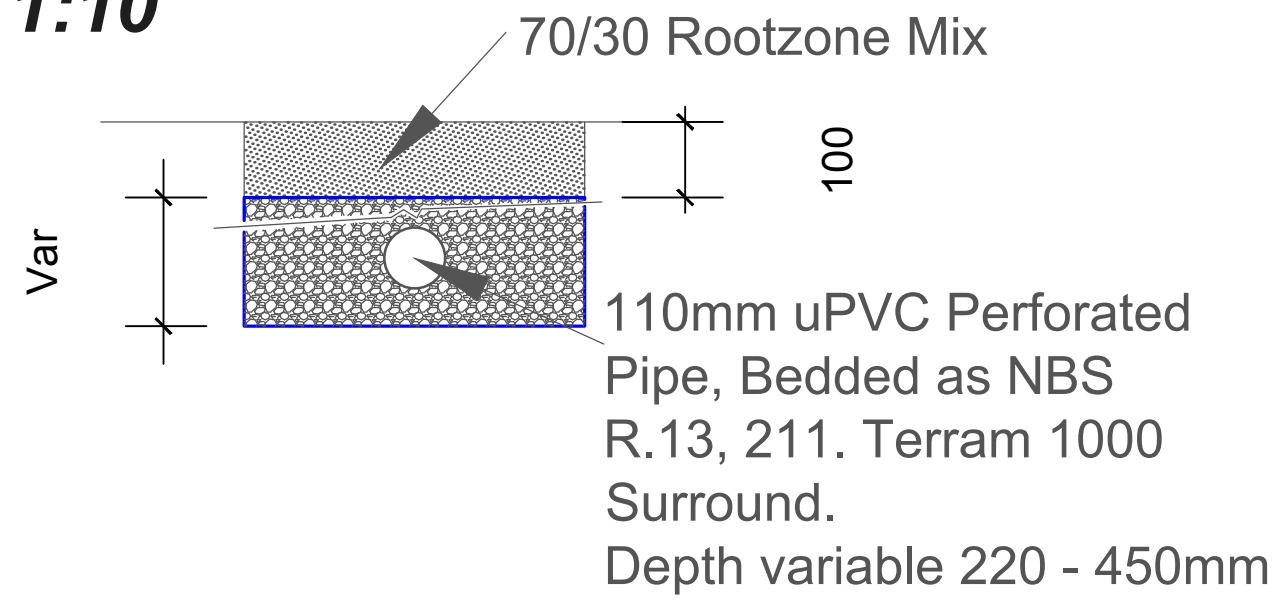


3 No. SWALES
Grade in flowing curves with a max gradient of 15°
Covered with topsoil from works, graded, cultivated & seeded.

MOUND FROM EXCAVATED MATERIALS
Grade in flowing curves with a max gradient of 15°.
Covered with topsoil from works, graded, cultivated & seeded.

110mm uPVC PERFORATED PIPE
set in pea gravel trench topped with
100mm 70/30 Rootzone Mix & seeded

Silt Trap

Silt Trap

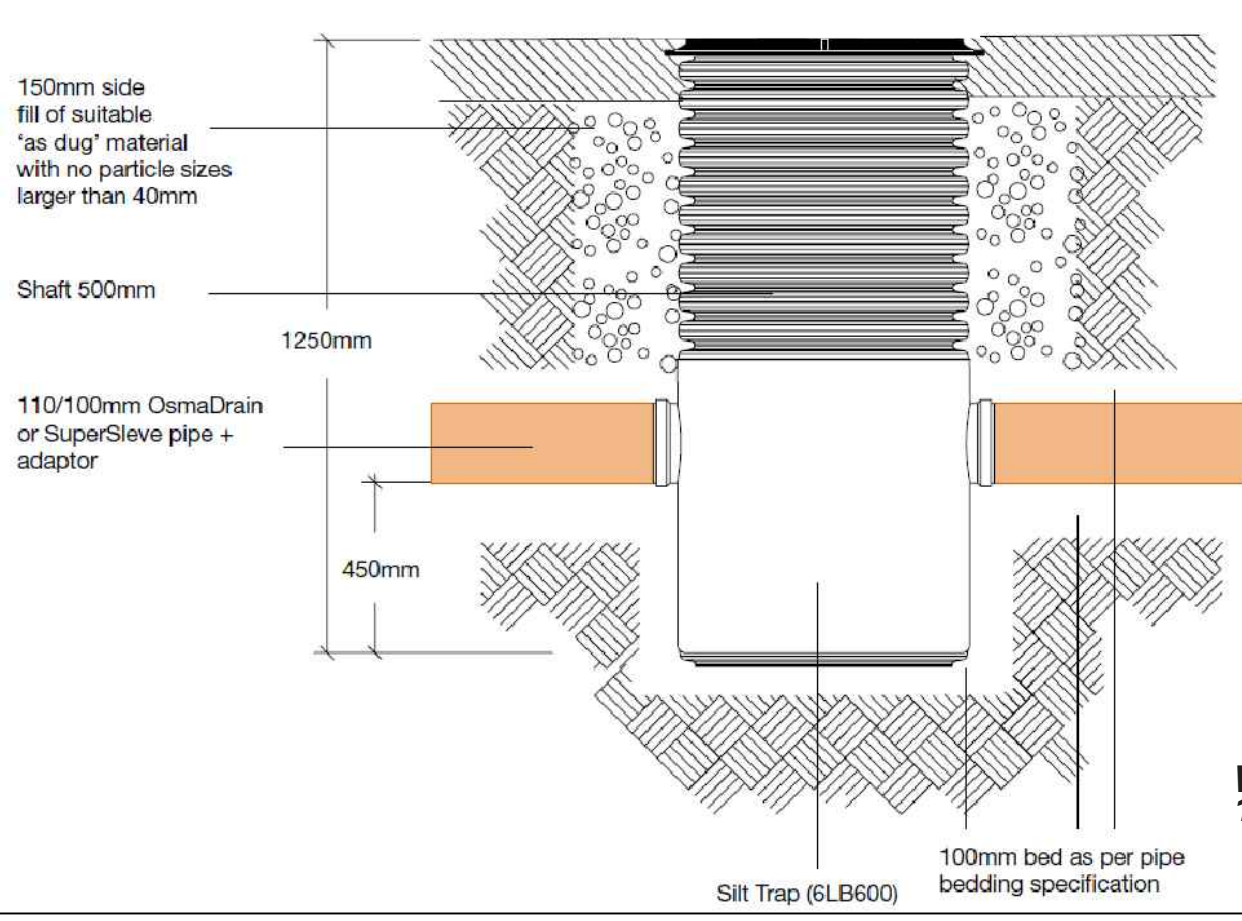


Typical installation procedure

1. Place the Silt Trap (6LB600) on a minimum of 100mm bed as per pipe bedding specification.
2. Connect the relevant pipework in accordance with standard pipe installation guidelines.
3. Surround the sides of the Silt Trap with 150mm of 'as dug' material, with no particle sizes larger than 40mm.
4. Fit relevant cover and frame.

WAVIN 6LB600 SILT TRAP
1:20

RESPONSIBILITY IS NOT ACCEPTED FOR OTHERS SCALING DIRECTLY FROM THIS DRAWING. DO NOT SCALE FROM THIS DRAWING. USE WRITTEN DIMENSIONS ONLY.

0 50 ORIGINAL SHEET SIZE A1

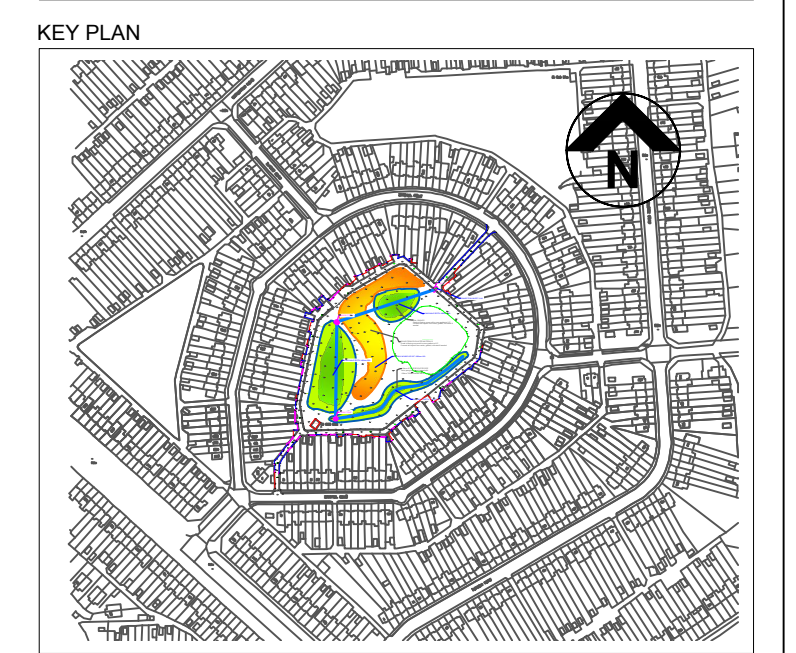

THIS DRAWING IS PRODUCED FOR USE IN THIS PROJECT ONLY AND MAY NOT BE USED FOR ANY OTHER PURPOSE. NPS PROPERTY CONSULTANTS LTD ACCEPT NO LIABILITY FOR THE USE OF THIS DRAWING OTHER THAN THE PURPOSE FOR WHICH IT WAS INTENDED IN CONNECTION WITH THIS PROJECT AS RECORDED IN THE 'PURPOSE FOR ISSUE' AND 'FILE STATUS CODE'.

THIS DRAWING MAY NOT BE REPRODUCED IN ANY FORM WITHOUT PRIOR WRITTEN AGREEMENT OF NPS PROPERTY CONSULTANTS LTD.

© CROWN COPYRIGHT AND DATABASE RIGHTS 2017 ORDNANCE SURVEY LICENCE NUMBER 100019567

Notes:

- 110mm uPVC SOLID PIPE & POLYPIPE RIGISTORM MINI SILT TRAP CHAMBER
- 110mm uPVC PERFORATED PIPE

AS-BUILT					
AB	pc	10/5/2017	BL	10/5/2017	

in partnership with

COMMENT	pc	24/10/16	HG	24/10/16
REV	DRAWN	DATE	CHECKED	DATE



CLIENT
KHCC

PROJECT
Bristol Road Flood Alleviation

TITLE
As-Built Drawing

SCALES	DISCIPLINE	PROJECT NUMBER
1:250	LAND ARCH	16-1-1378

DRAWING NUMBER	REV CODE
NPS-00-00-DR-L - 803	C1
STATUS CODE	PURPOSE OF ISSUE
AB	AS BUILT
	DRAWN BY
	pc/bl