


Area seeded area with GERMINAL A.19 @ 50g/m².



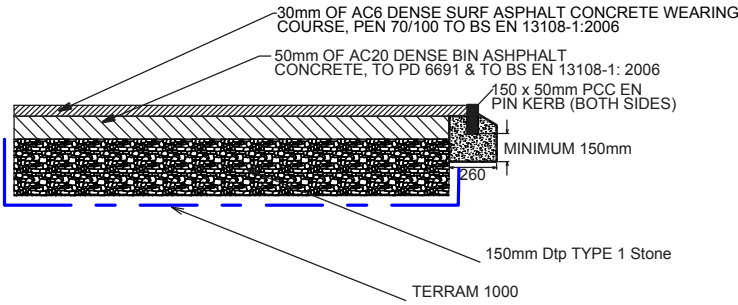

STANDARD MACADAM CONSTRUCTION-
FOOTPATHS 1:20



NOTES:

This drawing is produced for use in this project only and may not be used for any other purpose. NPS Property Consultants Ltd accept no liability for the use of this drawing other than the purpose for which it was intended in connection with this project as recorded on the title block fields 'Purpose for Issue' and 'File Status Code'.
This drawing may not be reproduced in any form without prior written agreement.
Do not scale from the drawing, use written dimensions only.

+1.40
1.42 - EXISTING LEVELS

As-Built				
AB	REVISED BY: pc	DATE: 10/5/17	CHECKED BY: BL	DATE: 10/5/17
in partnership with    				
SCALE BAR				
PURPOSE OF ISSUE				
AS-BUILT				
FILE STATUS CODE				
AB				
© COPYRIGHT NPS GROUP © Crown Copyright & Database Rights [2012] Ordnance Survey [100023272]				
A2				

NPS Property Consultants Ltd
Earle House
Colonial Street, Kingston Upon Hull
East Yorkshire, HU2 8JY
TEL: 01482 334477 FAX: 01482 334478
EMAIL: hull@nps.co.uk
Head Office:
Lancaster House, 10 Central Avenue, St Andrews Business Park,
Norwich, NR7 2PR Tel: 01603 706000 Fax: 01603 706001
Other Office locations can be found on our website: www.nps.co.uk


Property Design and Management Services
CLIENT
KHCC

PROJECT
Kingfisher Aqua Green

TITLE
As-Built Drawings

SCALES 1:200	DATE May 2017	DRAWN pc	CHECKED BL
-----------------	------------------	-------------	---------------

FILE / DRAWING NAME			REV CODE
PROJECT NR 16-1-1378	DRAWING FIELDS NPS-DR-L	UNIQUE NR 804	C1

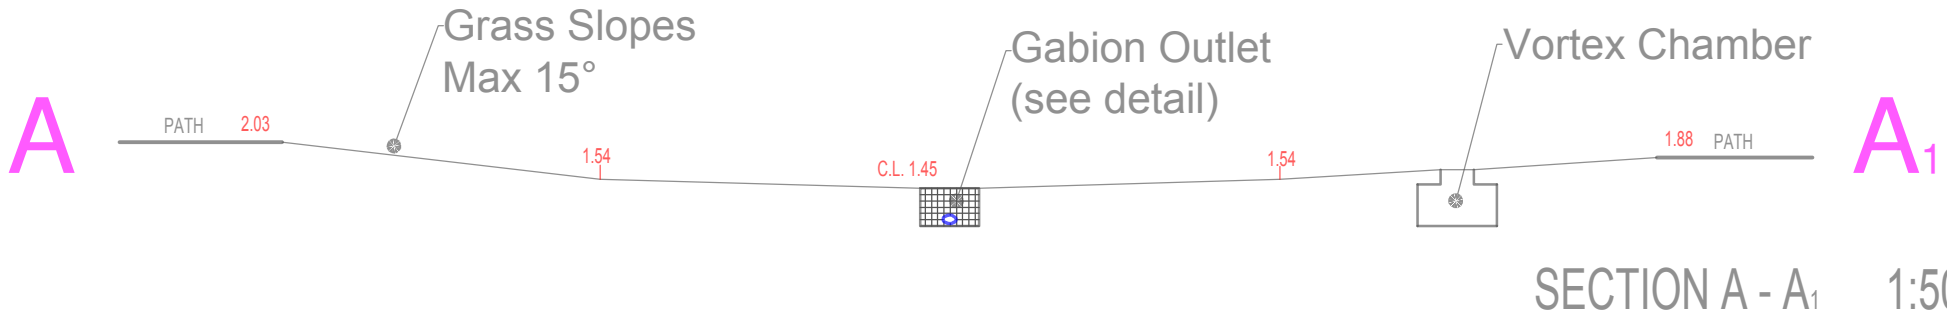

GABION OUTLET DETAIL 1:25

